
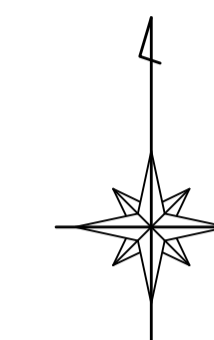



別府市下水道施設平面図

81-1-23	81-1-24	81-1-25
81-3-03	81-3-04	81-3-05
81-3-08	81-3-09	81-3-10

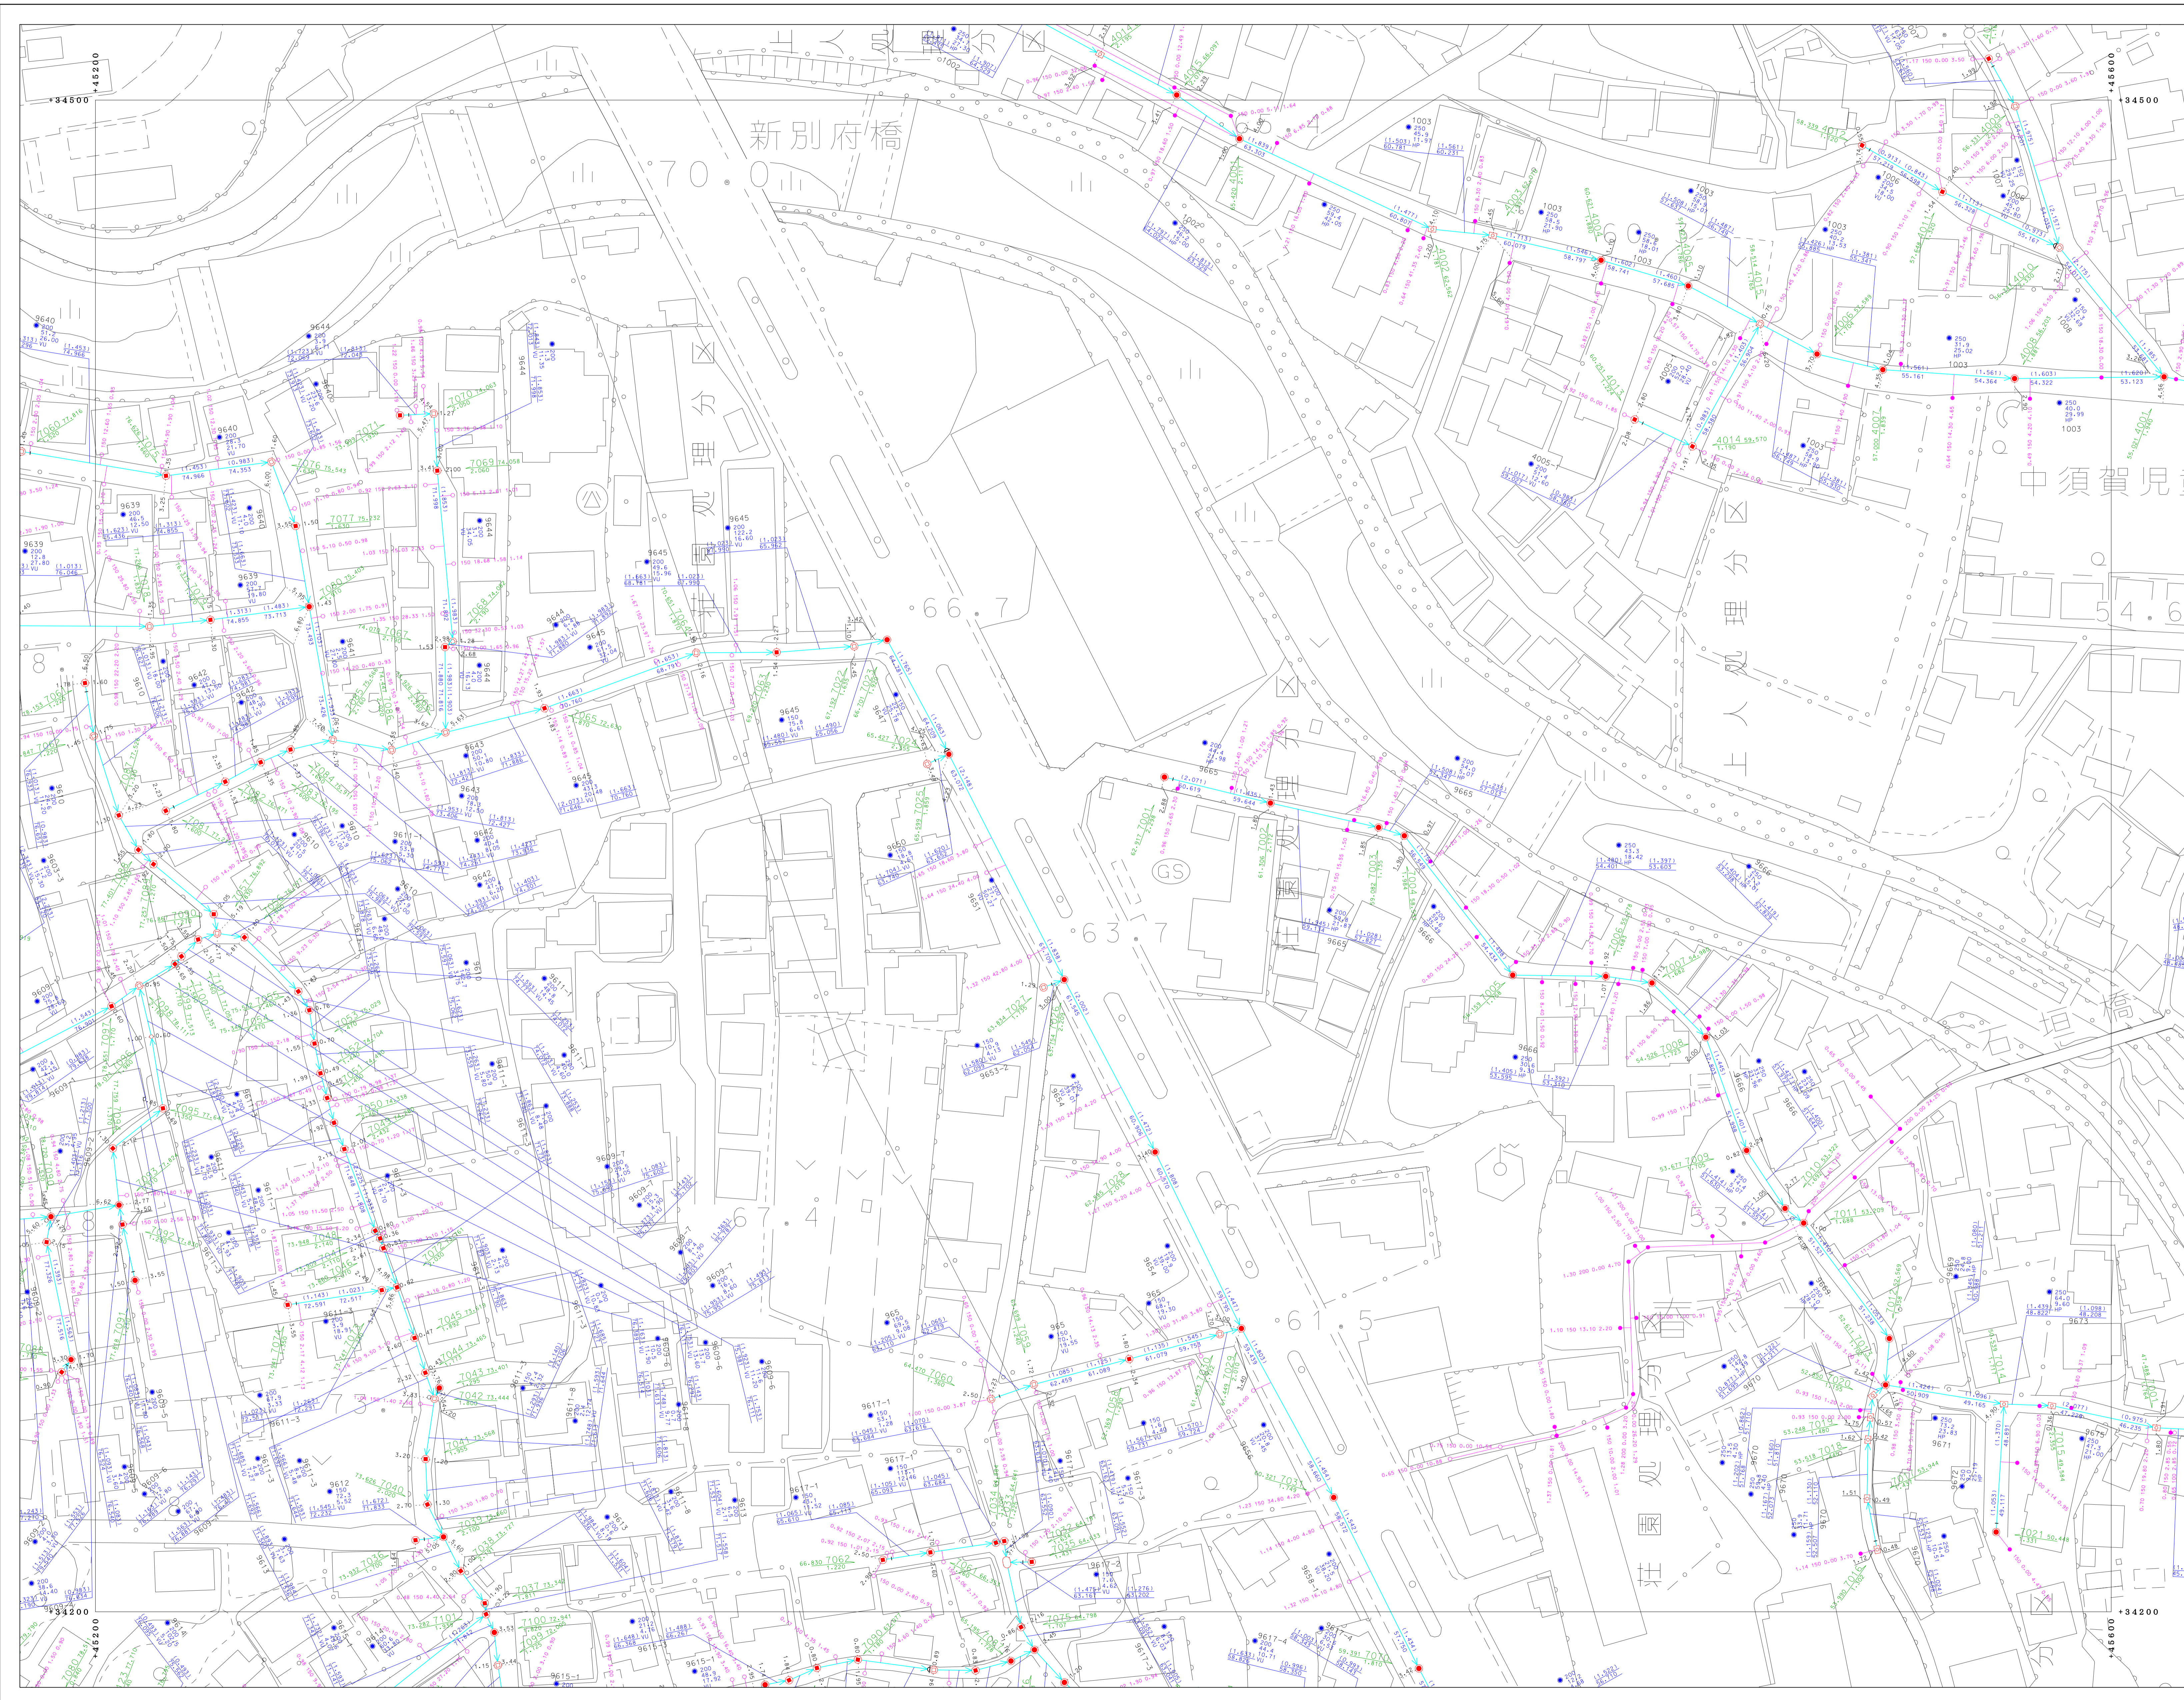

凡	例
別府市上下水道局 下水道課

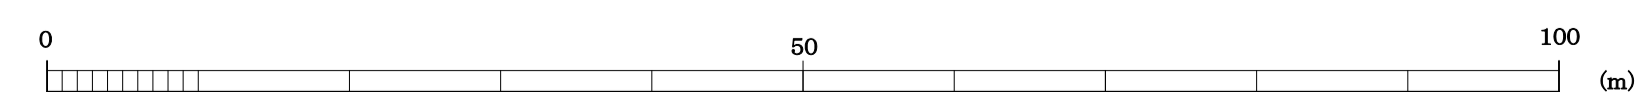

1:500

【座標は、世界測地系に対応】