



別府市下水道施設平面図

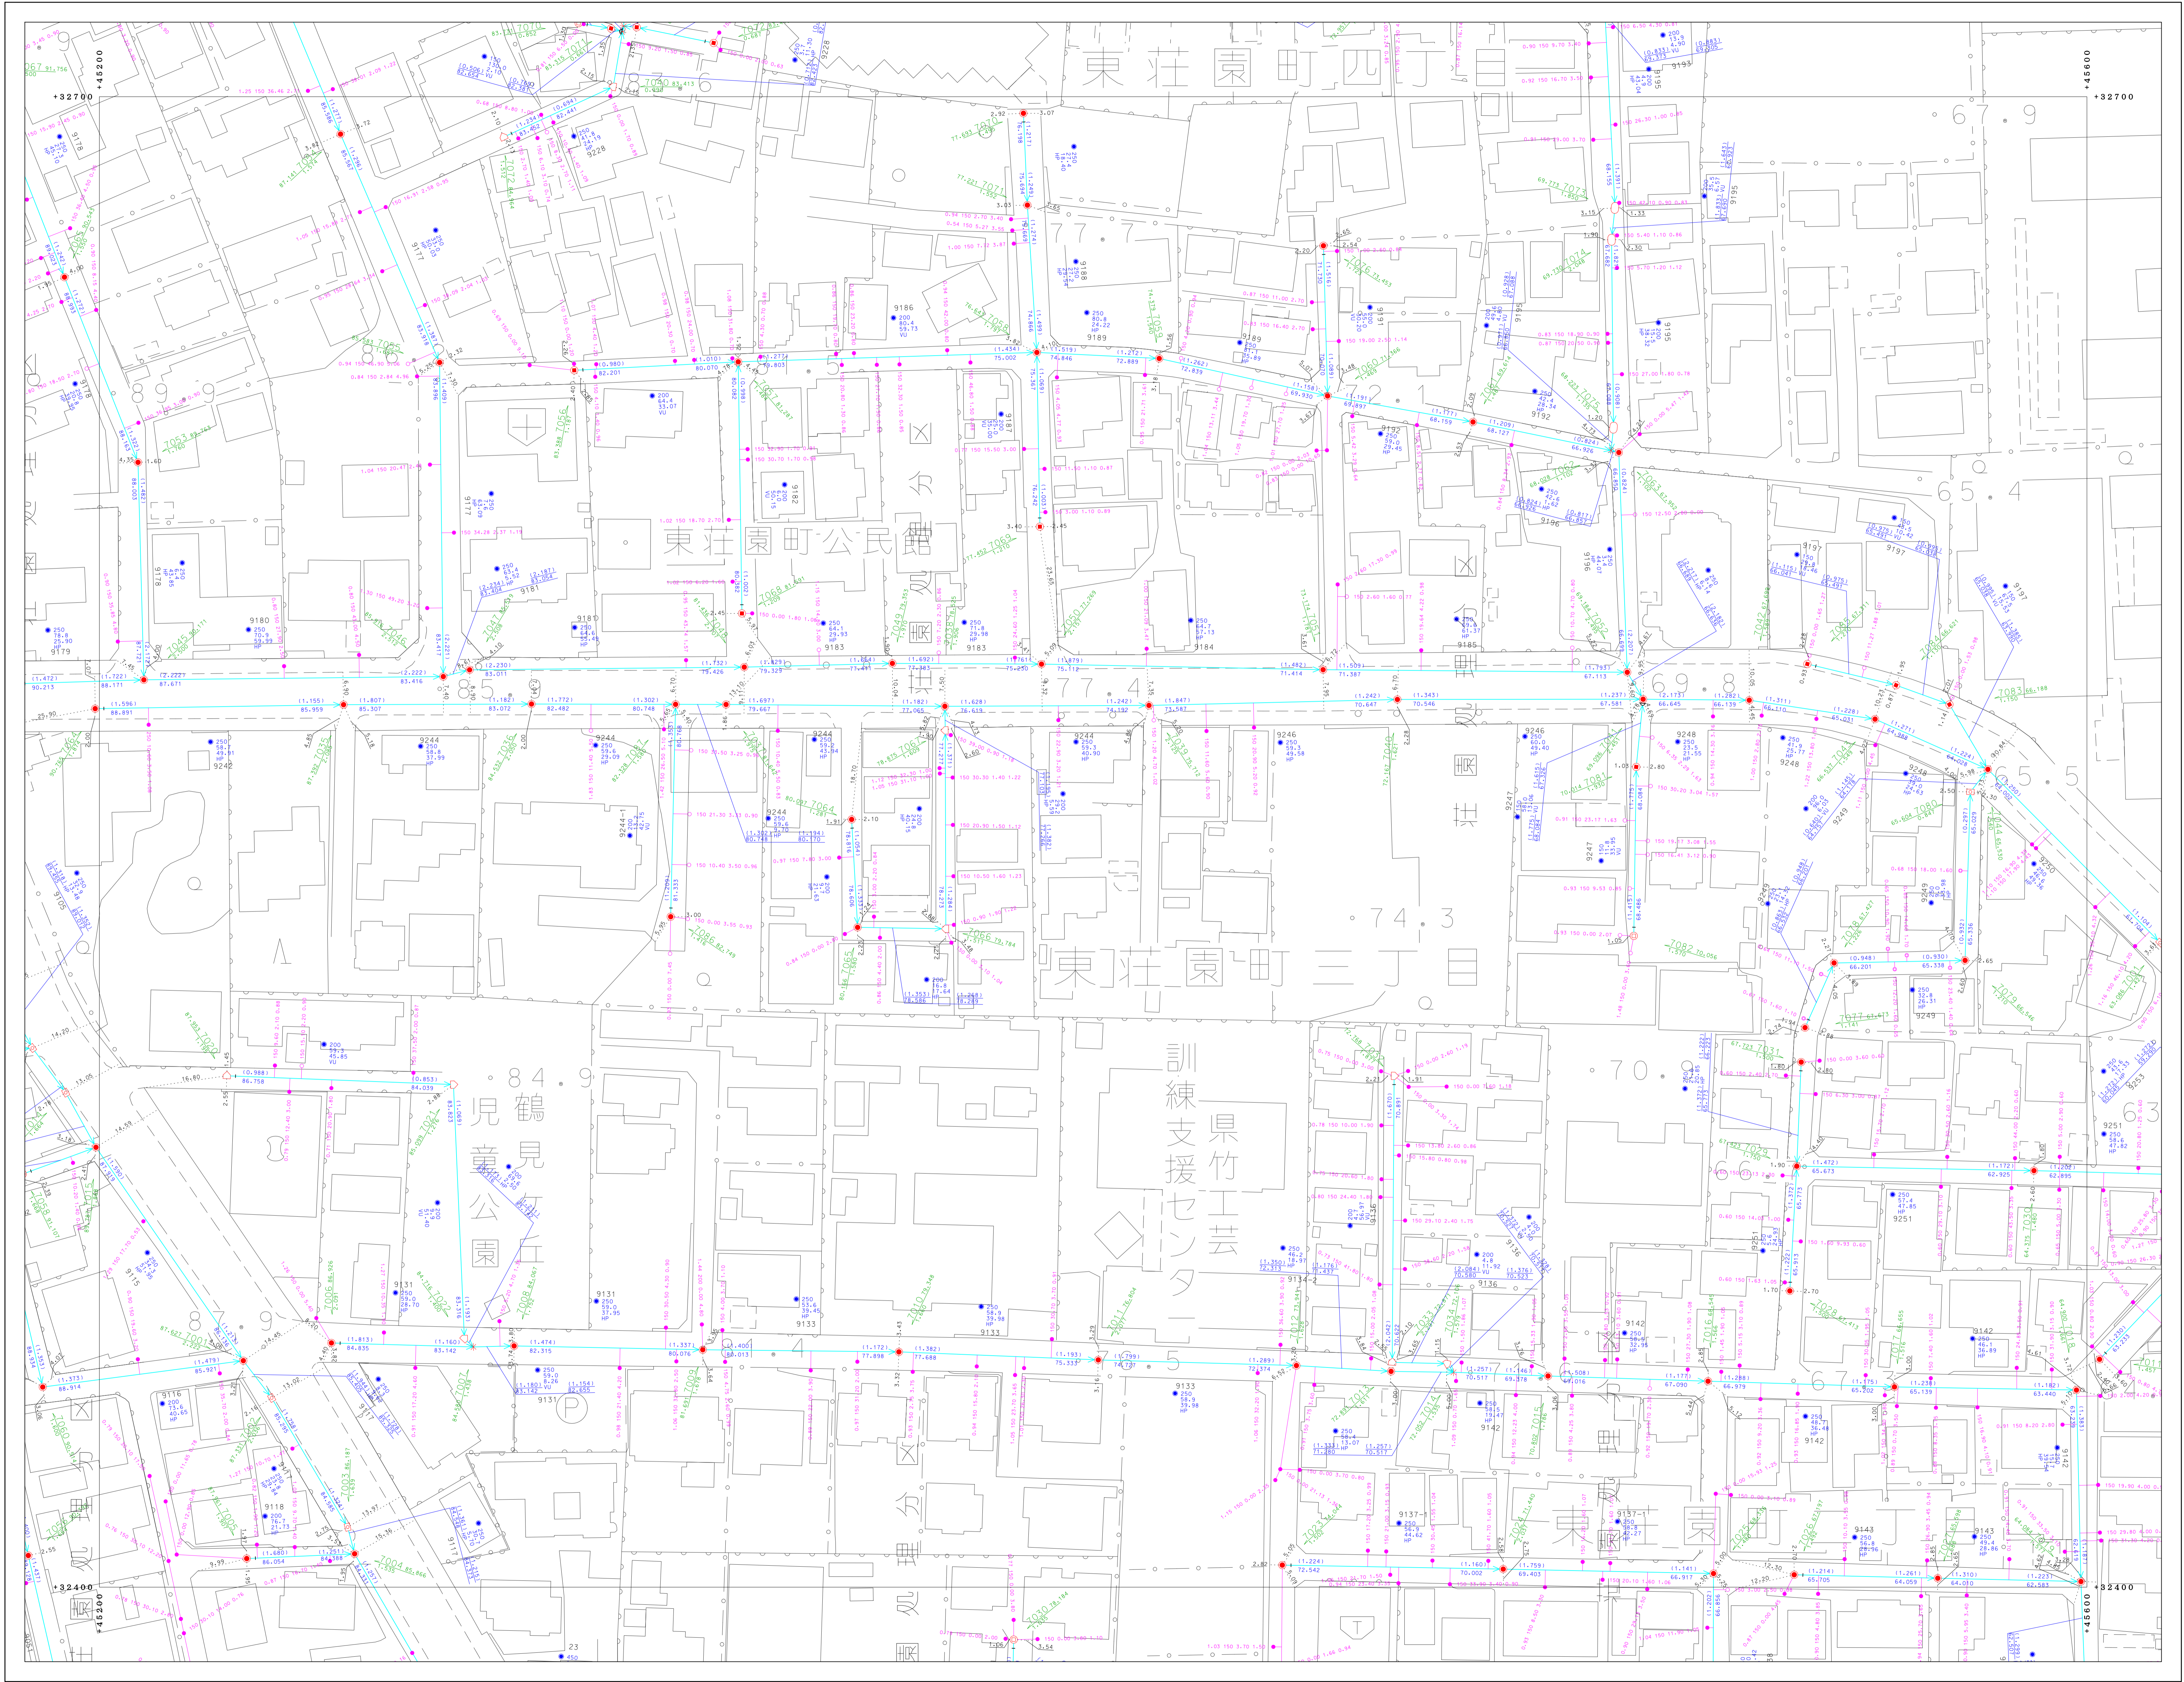


91-1-03	91-1-04	91-1-05
91-1-08	91-1-09	91-1-10
91-1-13	91-1-14	91-1-15

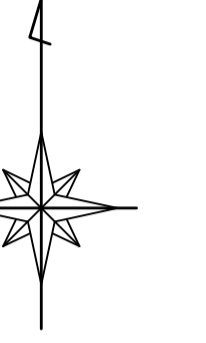

凡 例	
別府市上下水道局 下水道課

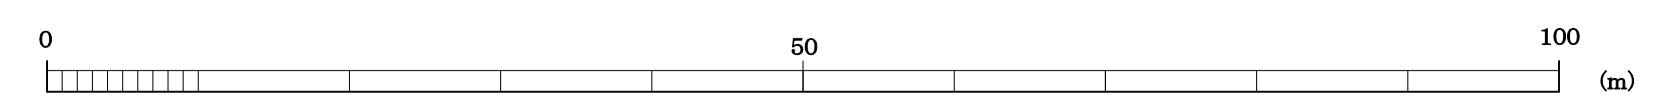

1:500

〔原簿は、測量測地系に準拠〕